# FE197

# FE197

Diagram No. 5530-5

NOAA FORM 76-35A

U.S. DEPARTMENT OF COMMERCE
NATIONAL OCEANIC AND ATMOSPHERIC ADMINISTRATION
NATIONAL OCEAN SURVEY

# DESCRIPTIVE REPORT

(HYDROGRAPHIC)


Type of Survey Tag & Circle Line Survey
Field No
Office No. FE-197
LOCALITY
State California
General Locality San Francisco
Locality North & South Piers of
Golden Gate Bridge
19
CHIEF OF PARTY F. Paulsen & P. Larsen
LIBRARY & ARCHIVES
DATE

☆ U.S. GOV. PRINTING OFFICE: 1976-669-441

NOTE: A new system for registering Field Examinations (FE's) was established in 1980. All FE's are now consecutively numbered as shown hereon. The date shown in the new format is the actual date of survey. This material was previously registered as;

FE No.4 1964

# FENO.4 1964

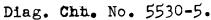

Form 504 U. S. COAST AND GEODETIC SURVEY DEPARTMENT OF COMMERCE DESCRIPTIVE REPORT Type of Survey Tag & Circle Line Survey Field No. Office No. F.E. No.4 (1964) **LOCALITY** State California General locality San Francisco Locality North & South Piers of Golden Gate Bridge 194 ..... CHIEF OF PARTY F. Paulsen and P. Larsen LIBRARY & ARCHIVES DATE .....

B-1870-1 (I

# DEPARTMENT OF COMMERCE

U. S. COAST AND GEODETIC SURVEY

# HYDROGRAPHIC TITLE SHEET

The Hydrographic Sheet should be accompanied by this form, filled in as completely as possible, when the sheet is forwarded to the Office.

REGISTER No. F.E.No.4-1964

Field No	
State Calif <b>or</b> nia .	
General locality San Francisco	
Locality North and South Piers of	Golden Gate Bridge
Scale 1"=251	Date of survey Sept. & Oct. 1964
Instructions dated	
Vessel Pioneer	
Chief of party F. Paulsen and P. I	arsen
Surveyed by	
Soundings taken by fathometer, graphic record	ler, hand lead, wire
Fathograms scaled by	
Fathograms checked by	
Protracted by	
Soundings penciled by	
Soundings in fathoms feet at M	ILW MLLW
Remarks:	

U. S. GOVERNMENT PRINTING OFFICE 777032

- put survey plots in envelope

### DESCRIPTIVE REPORT

Special Survey - Vicinity of piers of Golden Gate Bridge, 12 October 1964

- A. Instructions
  The work covered by this report was done in accordance with oral instructions from the San Francisco Regional Officer.
- B. Purpose and Scope
  The purpose of the survey was to take soundings at easily relocated positions to check erosion in the vicinity of the piers of the Golden Gate Bridge.
- C. Dates
  The work included six days of boat work totalling about fourteen boat hours working at slack water and two days of reconnaissance and locating control. The work was accomplished in late September and early October of 1964.
- D. Smooth Sheets
  Scale: 1 inch equals 25 feet
  No Projection
  Plotting was done by Ensign Fred Paulsen and verified by LTJG
  Paul Larsen
- E. Adequacy
  - 1. North Pier Tag Line Survey This survey along with the two previous surveys and future surveys is adequate for detection of major erosion changes.
  - 2. The South Pier Circle line survey which was the first of its kind, should be adequate when compared with previous surveys and similar future surveys, for detection of major erosion changes.
- F. Accuracy (by estimation)

  South Pier Circle line method (positioning)

  Along the length of the tag line.... 0 to -1 feet

  Perpendicular to the circle line.... + or 1.5 feet

  South Pier Circle line method (depths) + or 1 foot (fathometer)

  North Pier Tag line method (positinning)

  Positions + or 1 foot

  North Pier Tag line method (depths) + or 0.5 feet (lead line)
- G. Miscellaneous Commendation should be given to bridge authority employees who worked closely with the boat crew.

Golden Gate Bridge and Haghway Vistrict.
No verification made of plat.

2140



PLATE # 1
FOG AND TRAFFIC IN SURVEY VICINITY

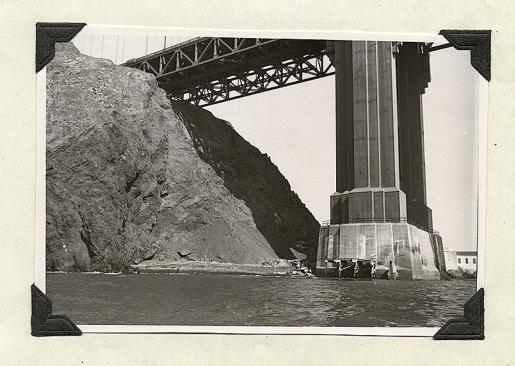


PLATE # 2 . VICINITY OF NORTH PIER


### NORTH PIER (MARIN PIER)

Work on the North pier was accomplished using tag lines for control. One in stainless steel cable was used. It was 275 feet long and marked with a tag every 25 feet. The bridge authority supplied the cable, the same one used in previous surveys. A lead line marked in feet was used to measure the depth. The boat was a heavy duty 16 foot rowboat powered by a 10 HP Johnson engine with gear shift. Three men on the pier and three men in the boat were necessary. One man was required ashore to read the tide staff at Fort Point Coast Guard Station. A reading of 2.0 feet on the tide staff was used as MLIW. All shore personnel were supplied by the bridge authority.

The three people in the boat were:

- 1. Coxain recorder officer in charge
- 2. Lead line Handler
- 3. Tag line Handler


For soundings off of the face of the North Pier the tag line was handled as described by the following illustrations and description.

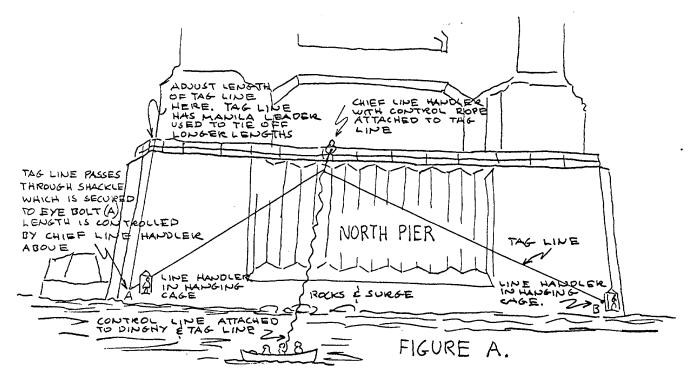

- 1. The tag line is put into position by the shore personnel.


  (Figure A)
- 2. The chief line handler throws monkey fist to dinghy which then strongly backs down and away putting tension on the control line and the tag line is eased over the rocks and foul area by the chief line handler.
- 3. The length of the tag line was controlled by the chief line handler by adjusting the portion of the tag line that runs up to the rail as shown.
- 4. The two line handlers in the cages were necessary for securing the lines initially. The handlers at A and B took up slack in the wire if the boat wasn't able to maintain tension. The handler at A opened and closed the shackle to allow the tags past when adjusting the length of the line.
- 5. A walkie talkie in the boat and up on the pier with the chief line handler proved useful.

6. It was found that optimum procedure was to back the boat down at almost full speed on the ten HP motor - all of the time - and let the position of the boat be altered by manually pulling along the tag line and changing the heading of the outboard motor. See Figure B.

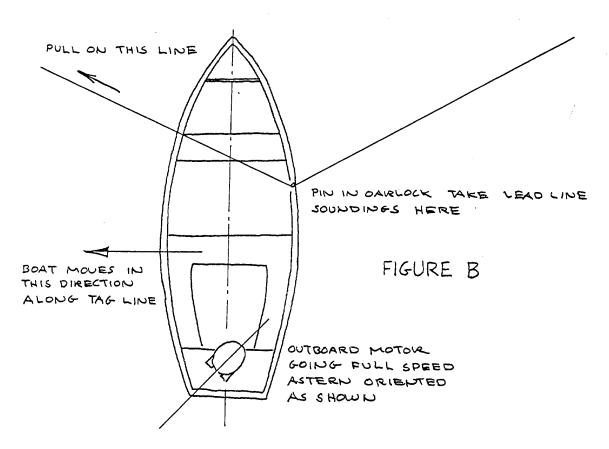

For the soundings South West of the North Pier the tag line was handled as follows: See Figure C.

- 1. The line handlers got the line into position as shown.
- 2. Both the chief line handler and the line handler at A had control lines.

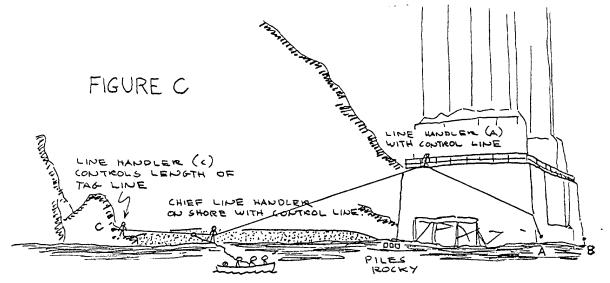

CONTROL LINE ATTACHED TO TAG LINE WITH LARGE, SLIDING, SHACKLE IS PASSED TO BOAT AT C. THE BOAT, THE CHIEF LINE HANDLER (A) WORK TOGETHER TO MANEUVER TAG LINE OVER OBSTRUCTIONS TO WORKING POSITION.

- 3. The boat maneuvered close to the rocks at point C and received a control line attached to the tag line with a large shackle.

  Then the boat backed down using full power and co-ordinating the control lines with the pull of the outboard, the line was eased over the obstructions and out into clear water to begin the survey.
- 4. Weather and current conditions:
  - a. winds generally pick up in the afternoon.
  - b. Ebb current seems to have little effect in the vicinity of the North Pier. Flood current is quite strong.


### 5. Recommendations


- a. It is recommended that all control lines attached to the tag line be secured with shackles that will slide easily along the tag line and not foul on the tags clamped to the wire.
- b. Supply the tag line handler in the boat with gloves.

### SOUTH PIER

Six eye bolts were set in the face of the fender enclosing the south pier by bridge authority employees as prescribed by the officer in charge. On the top of the fender, holes were drilled to mark the location of the eye bolts. It was found that due to the strong currents and seeming lack of slack water in the vicinity of the South Pier the tag line method would not work. Therefore the circle line method was adopted using only one tag line and a sextant angle to define position. Because of the depth and current it was decided to use a fathometer instead of a leadline. The system proved quite workable and a description follows.

The survey positions were pre - planned as shown on figure (E) and the sextant man preset his angles and gave a visual hand signal "mark" to the recorder in the boat as it swung in a circular arc as shown in figure (D).

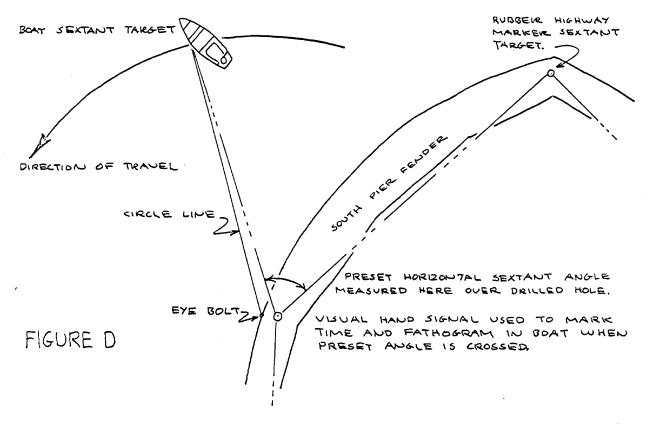

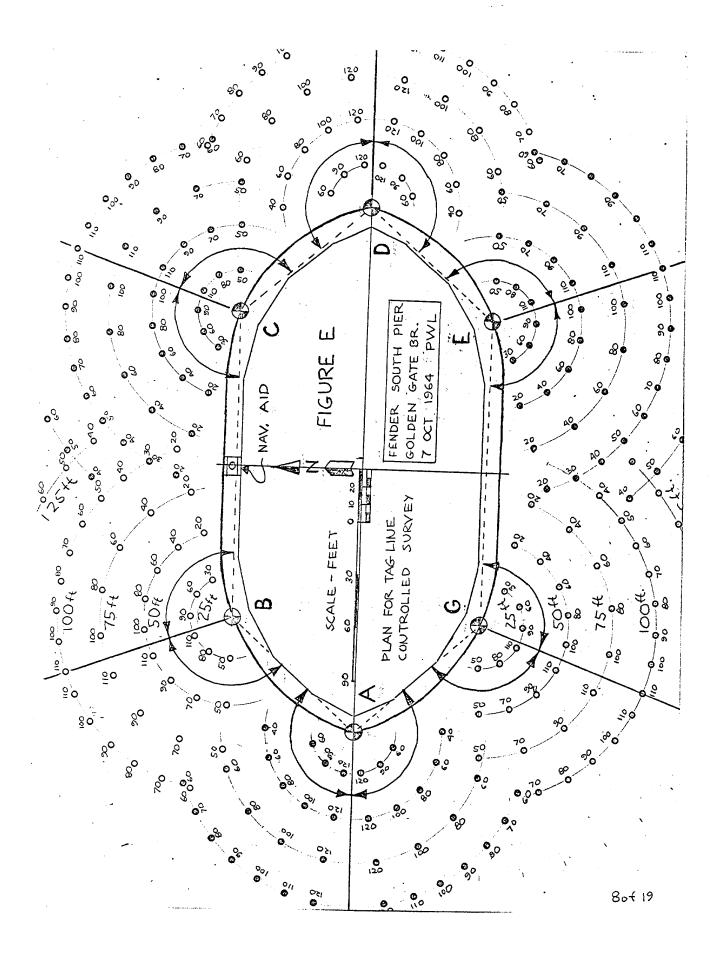

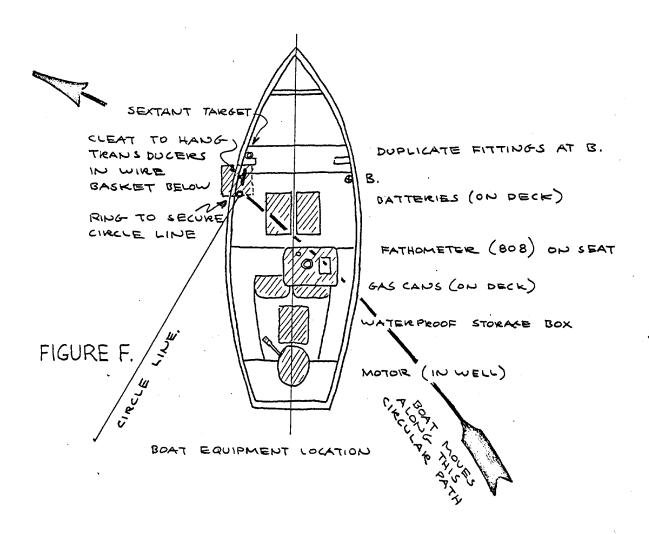


Figure F. Duplicate fittings were necessary at A and B so that the boat could operate in either a clockwise or counterclockwise mode depending on the currents. See Plates #3 and #4.



PLATE # 3



PLATE # 4

Plates three and four show the wire basket in which the transducers were tied and the general orientation of equipment in the boat.

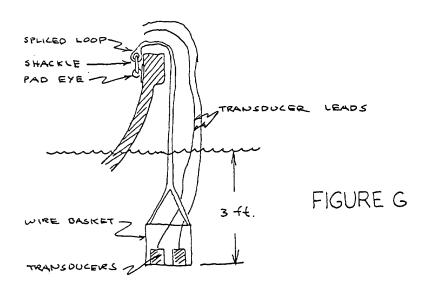


Figure G. Mounting the transducers in an open wire basket kept them hanging more or less vertically while the boat rocked. No problems with side echos were experienced. The open wire basket gave little lateral resistance and the current had little effect upon the orientation of the transducers. Due to the proximity of the transducers it was impossible to eliminate the initial, limiting this method to water at least 12 to 15 feet deep.


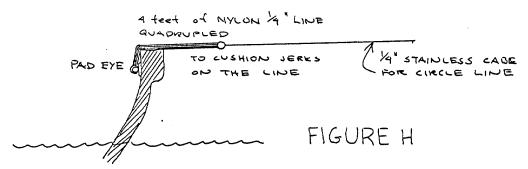


Figure H. Using four feet of nylon the length of the cable, which is marked in 25 foot lengths, must be correspondingly adjusted.

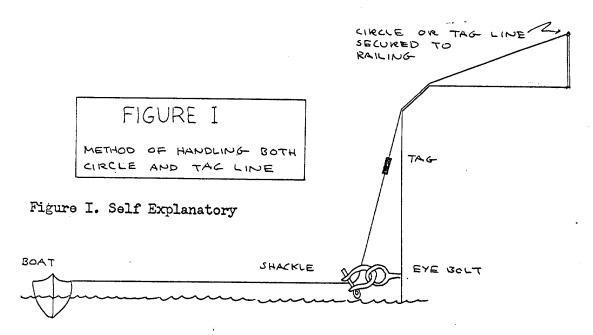

Personnel in the boat:

- 1. Coxwain Officer in charge
- 2. Recorder time keeper
- 3. Line Handler Asst. recorder who marked and notated fathogram. The sounding volume was set up ahead of time using the planning sheet and each arc numbered from 1. Since as many as six positions were taken a minute an abbreviated identification system was used. Each arc was identified on the fathogram by a letter indicating the eye bolt used and the length of the tag line. (example C75) Each successive sounding was numbered using the first position of the arc as number one.

Personnel on the pier:

- 1. Chief line handler
- 2. Asst. Line handler
  - 3. Sextant man


Again, one man was required to read the tide staff at Fort Point Coast Guard Station.

A special ladder was used by Bridge personnel to handle the tag line. See Plate # 5.




PLATE # 5

See figure J for a description of eye bolts and target hole location.

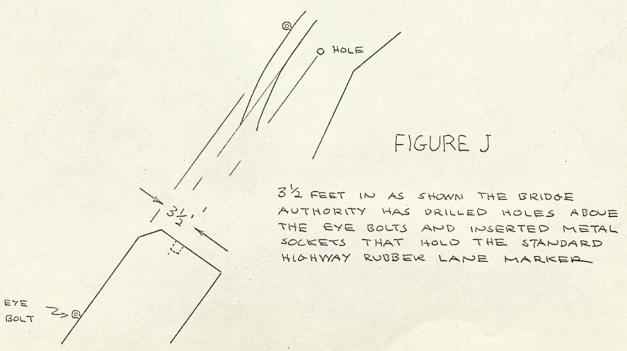

The target holes were located with a closed loop travers used in plotting.

Soundings were taken with a lead line along the face of the pier opposite all interior angles and in the center of the pier as shown on smooth sheet.

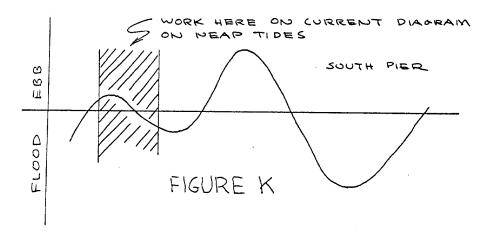

Weather and current conditions:

It was found in the course of operations that the only satisfactory time to work in the vicinity of the South Pier was as shown on figure K.

Respectfully Submitted

Paul W. Larsen LTJG USC&GS

Hydrographer

Approved:

### APPENDIX


NORTH PIER: The positions taken in the vicinity of the North pier are explained on the chart. (tag line method)

SOUTH PIER: Depths are shown as heavy numbers and position numbers are shown in parenthesis. The exact location is indicated by a small dot between the two numbers. Description of the positions follows using codes.

- 1. The first two digits give the length of the circle line.
- 2. The first letter (in parenthesis) indicates the station occupied by the sextant man.
- 3. The second letter shows from which point on the pier the sextant man was measuring the angle to the target on the boat.
- 4. The last digits give the angle read by the sextant man in degrees.

Positinn Number	Location		Position Number	Location
1. 2. 3. 4. 5. 6.	50(C)D50 70 90 110 50(C)B100		44. 45. 46. 47. 48. 49. 50.	75(D)E60 · 80 · 100 · 120 · 75(D)C120 · 100 · 80 ·
7. 8. 9.	60 · 40 · 20 ·		51. 52.	60· 100(D)E60·
10. 11. 12. 13. 14. 15. 16. 17. 18.	75(C)D50 70 90 110 75(C)B100 80 60 40		53. 54. 55. 56. 57. 58. 59. 60. 61.	70. 80. 90. 100. 110. 120. 100(D)C120. 110. 100.
19. 20. 21. 22. 23. 24. 25. 26. 27. 28. 29. 30. 31. 32. 33.	100(C)D60 · 70 · 80 · 90 · 100 · 110 · 100 (C)B110 · 100 · 90 · 90 · 90 · 90 · 90 · 90	_	63. 64. 65. 66. 67. 68. 69. 70. 71. 72. 73. 74. 75. 76. 77.	80 · 70 · 60 · 60 · 60 · 60 · 60 · 60 · 6
34. 35. 36. 37. 38. 39. 40. 41. 42. 43.	50(D)C40 60 80 100 120 50(D)E40 60 80 100 120		78. 79. 80. 81. 82. 199. 200. 201. 202. 203. 204. 205. 206. 207.	100. 75(B)A 110. 100. 70. 50. 100(B)C50. 60. 70. 80. 90. 100(B)A110. 100. 90. 80.

Position Number	Location	Position Number	Location
02	ro(h) a.co.:		
83.	50(A)G120	130.	75(G)A50·
84.	100 ·	131.	70.
85 <b>.</b> 86.	80 ·	132.	90 <sup>.</sup>
86.	60·	133.	1107 Soundings
87.	40 ·	134.	75(G)E100) Missed
88.	50(A)B40·	135.	80.
89.	60 ·	136.	60.
90.	80	127	40.
91.	100 -	137•	
92.	120 ·	138.	20 ·
74.	120 ·	100	(1)
00	mr/1)m/n	139•	100 (G)A90
98.	75(A)B60·	140.	100-
99•	80 -	141.	110
100.	100 -	142.	100 (G)E110 ·
101.	120 ·	143.	100.
102.	75(A)G120 ·	144.	90 -
103.	100 ·	145.	80.
104.	80 ⋅	146.	70 ·
105.	60 ·	147.	60.
သည်းအကြီးသံ သည် မကြားကြား		148.	50 ·
106.	100 (A) B50 ·	149.	40.
107.	60 ·		30 ·
108.	70	150.	
109.	80.	151.	20.
		450	50 (D) also
110.	90.	152.	50 (E) G40 ·
111.	100 ·	153.	60 -
112.	110.	154.	80 ·
113•	120	155• 156•	100.
114.	100(A)G120´	156.	50(E)D110·
115•	110	157• 158•	90
116.	100 .	158.	70 -
117.	90 ·	159.	50 ·
118.	80 -		<b>J</b>
119.	70 ·	160.	75(E)G40·
120.	60 ·	161.	60.
121.	50 ·	162.	80 ·
7~ 1.	<b>J</b> ♥	163.	
122.	50(G)A50 ·	164 <b>.</b>	100·
123.		104.	75(E)D110.
	70 · 90 ·	165.	90 •
124.		166.	70 -
125.	110	167.	50 ·
126.	50 (G) E 100 sounding	4-	
127.	80 ·	168.	100(E)G70·
128.	60.	169.	80 -
129.	40 .	170.	90 ·
		171.	100.
		172.	110 ·
		173.	100(E)D110
		174.	100.
		175.	90 ·
		176.	80.
		177.	70·
			•
		178.	60 · .

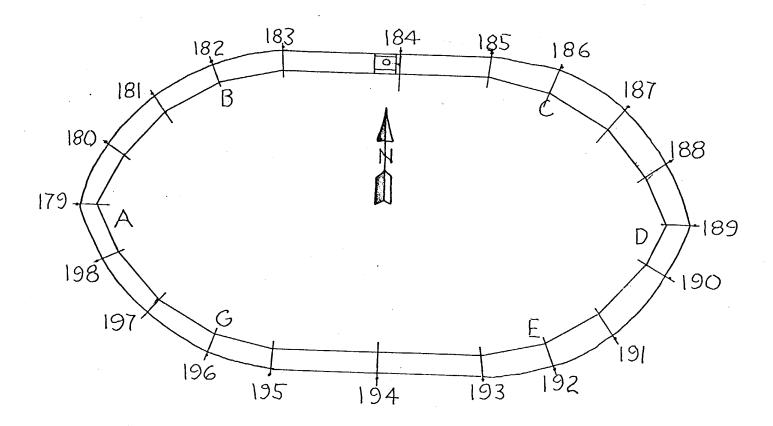

POSITION NUMBERS 179 to 198 SHOW THE LOCATION OF LEAD LINE SOUNDINGS TAKEN ALONG THE FACE OF THE FENDER AT THE SOUTH PIER OF THE GOLDEN GATE BRIDGE. SOUNDINGS WERE TAKEN OPPOSITE THE INTERIOR ANGLES OF THE FENDER AS SHOWN. POSITIONS 184 AND 194 WERE TAKEN AT THE NORTH EAST CORNER OF THE NAVIGATIONAL STRUCTURE AND OPPOSITE A LARGE CYLINDRICAL BOLLARD ON THE SOUTH SIDE OF THE FENDER RESPECTIVELY.

	•					•				
Poi	nt Interior Angle	Angle of leg w/rt coord axis	Sine	Cosine	Length of leg	E Coo +	ordinates -	N Coo	ordinates -	Coordinates + E - N
A G	422 606				•					
	133 ∞24	0 ∞0	0.000	1.000	166.20	166.2 166.2	7 T +007	-0.00	-0.07	100.00 0.00 100.00 0.00
E	133 041					63 17	,			266.27 <b>-</b> 0.07 <del>266.20 0.00</del>
4.		46°19	0.72317	0.69067	91.40	63.17	+004	66.10	) -0·03	266.20.0.00
D	92°14				٠		1711			329.44 66.00 <del>329.33 66.10</del>
		134∞5	0.71833	0.69570	96.60	+0.04	67.16	69.33 69 <b>.</b> 39	- -0:04	<del>329.33 66.10</del>
C	133 938						20	•		262.28 135.35 <del>262.13 135.49</del>
		180 27	0.00785	0.99997	163.50	+0.07	/63 <i>-43</i> _163 <b>.5</b> 0	-0.06	1.34 - <del>1.28</del>	262.13 135.49
В	133°11									98.85 134.01 98.63 134.21
		227°16	0.73452	0.67859	91.35	+0.03	6/.96 - <del>61.99</del>	-0.03	67.13 <del>67.10</del>	98.63 134.21
A	93256					(7.11		•	•	36.89 66.88
-		313°20	0.72737	0.68624	91.90	-63.07	+0.04	-0.03	66.88 -66.85	36.64 67.11
G,	•							-		100.00 0.00
Tota	ls 720 °04	•								<del>99.71 0.26</del>
	1 01			Adius	700.95	292 <b>.</b> 40 +0 <b>.</b> 29	292.69	135.49	135.23	+0.29 -0.26
	•					10.29		-(	) <b>.</b> 26	

TRAVERSE ADJUSTMENT SOUTH PIER GOLDEN GATE BRIDGE USE G \_ E AS X AXIS WITH POINT G HAVING COORDINATES OF +100.+0.00

## FE 4 (1964) Vicinity Piers at Golden Gate Bridge

Comparison between FE 1 (1956) and the present survey in the vicinity of the North Pier reveals a deepening of 3 to 4 ft west of the pier, little change from southwest of the pier to south of the center and a deepening of 2 ft. south of the east half of the pier. However, south of the pier in depths of about 40 ft. a deepening of 3-4 ft has occurred.


A comparison between H-7717 (1948) scale 1:2400 and the present survey reveals a deepening of 2-5 ft. in most areas around the South Pier. Scouring of 10 ft. is indicated next to the pier in several places. Prior depths of 103 to 110 ft. found in a slight deep 50 ft. off the northeast face of the pier have shoaled to about 93 ft. About 35 ft. beyond the prior deep, scouring of 10 ft. has occurred in prior depths of 93 to 104 ft.


Review considered completed,


R. H. Carstens 11/20/64

FORM C&GS-413 U.S. DEPARTMENT OF COAST AND GEODE	COMMERCE REFERENCE NO.
33.07 2.052	PI _ 64 - 93
LETTER TRANSMITTING DATA	DATA AS LISTED BELOW WERE FORWARDED TO YOU BY (Check):
	ORDINARY MAIL AIR MAIL
то:	REGISTERED MAIL EXPRESS
Golden Gate Bridge and Highway Dista Box 9000	GBL (Give number)
Presidio Station San Francisco, Calif.	DATE FORWARDED
L	29 October 1964
	NUMBER OF PACKAGES 1 package (number 38)
NOTE: A separate transmittal letter is to be used for each etc. State the number of packages and include an executed tion the original and one copy of the letter should be ser receipt. This form should not be used for correspondence of	copy of the transmittal letter in each package. In addi- nt under separate cover. The copy will be returned as a
1. Current Reference Book	
1. Tide Book	1 records forward to:
1. Sounding Volume	
3. Fathograms	
1. Boat Shoot for North Pier	
3. South Pier Work Sheets	
1. Descriptive Report	
1. Smooth Sheet North Pier Survey	
1. Phote Tracing " " "	
1. Smooth Sheet South " "	
1. Photo Tencing " " "	
FRUM: (Signature)	RECEIVED THE ABOVE
E. B. Brown, Commanding Officer, USCAGES PIC	(Name, Division, Date)
Return receipted copy to:	ARTHUR C. JENKINS
Commanding Officer USCACSS PIONEER 121 CUSTOMHOUSE San Prancisco, Galif. 94111	ENGINEER GOLDEN GATE BRIDGE AND HIGHWAY DISTRICT  OCT 29 1964
Ł	ı .

FORM C&G\$-413 (12-8-61)	U.S. DEPARTMENT OF COMMERCE COAST AND GEODETIC SURVEY	REFERENCE NO.			
		PI - 64 - 94			
LETTER TRANSMITTING DATA		DATA AS LISTED BELOW WERE FORWARDED TO YOU BY (Check):			
		ORDINARY MAIL AIR MAIL			
T0:	٦	REGISTERED MAIL EXPRESS			
	The Director US Department of Commerce Coast and Geodetic Survey	GBL (Give number)			
	Washington Science Center	DATE FORWARDED			
L.	Rockville, Maryland 20852	3 November 1964			
		NUMBER OF PACKAGES			
	<del></del>	One package (#39)			
etc. State t	eparate transmittal letter is to be used for each type of da he number of packages and include an executed copy of the ginal and one copy of the letter should be sent under sep is form should not be used for correspondence or transmitti	e transmittal letter in each package. In addi- parate cover. The copy will be returned as a			
(	One copy of Survey of Golden Gate Bridge Pic Golden Gate Bridge Authority.	er Vicinity done for			
ED(IM. (Cir.		RECEIVED THE ABOVE			
E. B. Bro	own, Commendating Officer, USCAGS PIONEER	(Name, Division, Date)			
T 1	Commanding Officer SC&GSS PIONEER 121 Customhouse San Francisco, Calif. 94111				
i	1	<u> </u>			

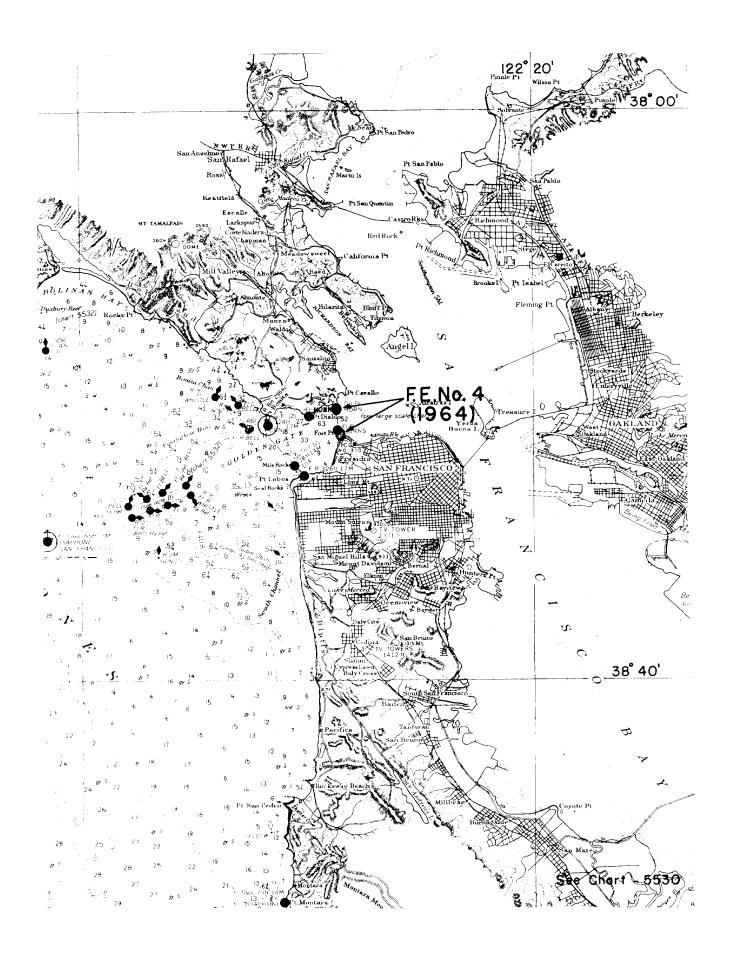

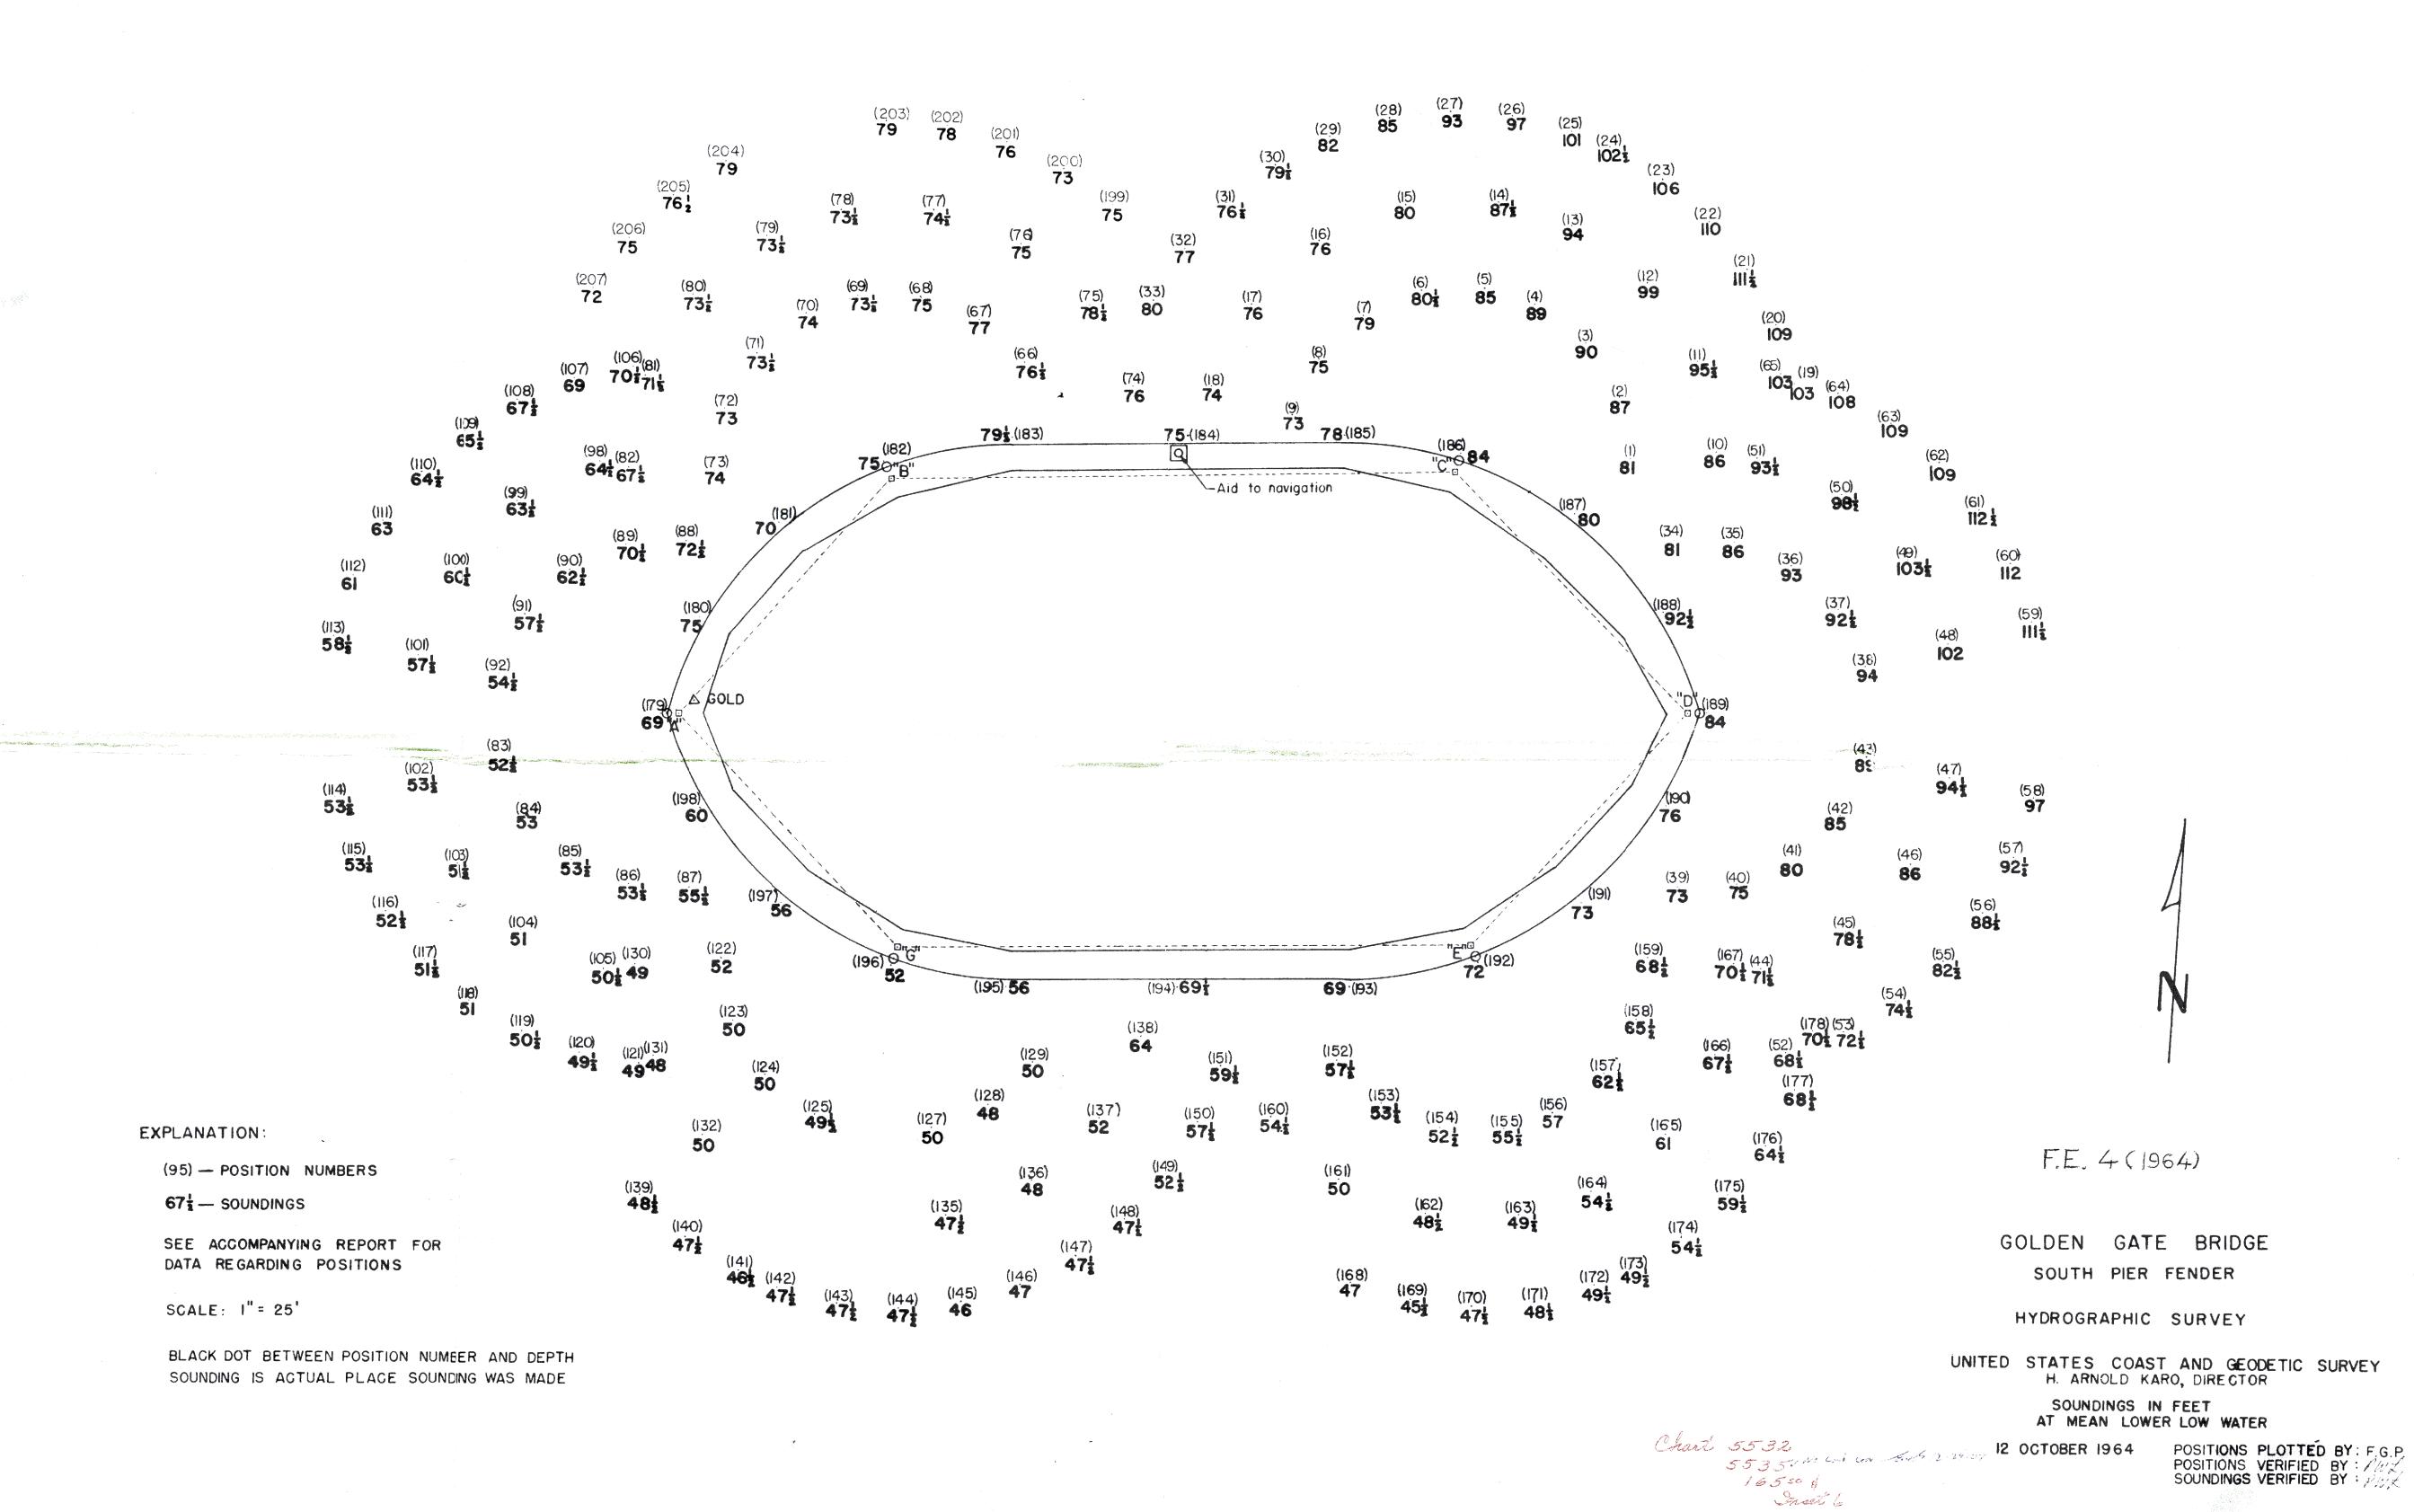

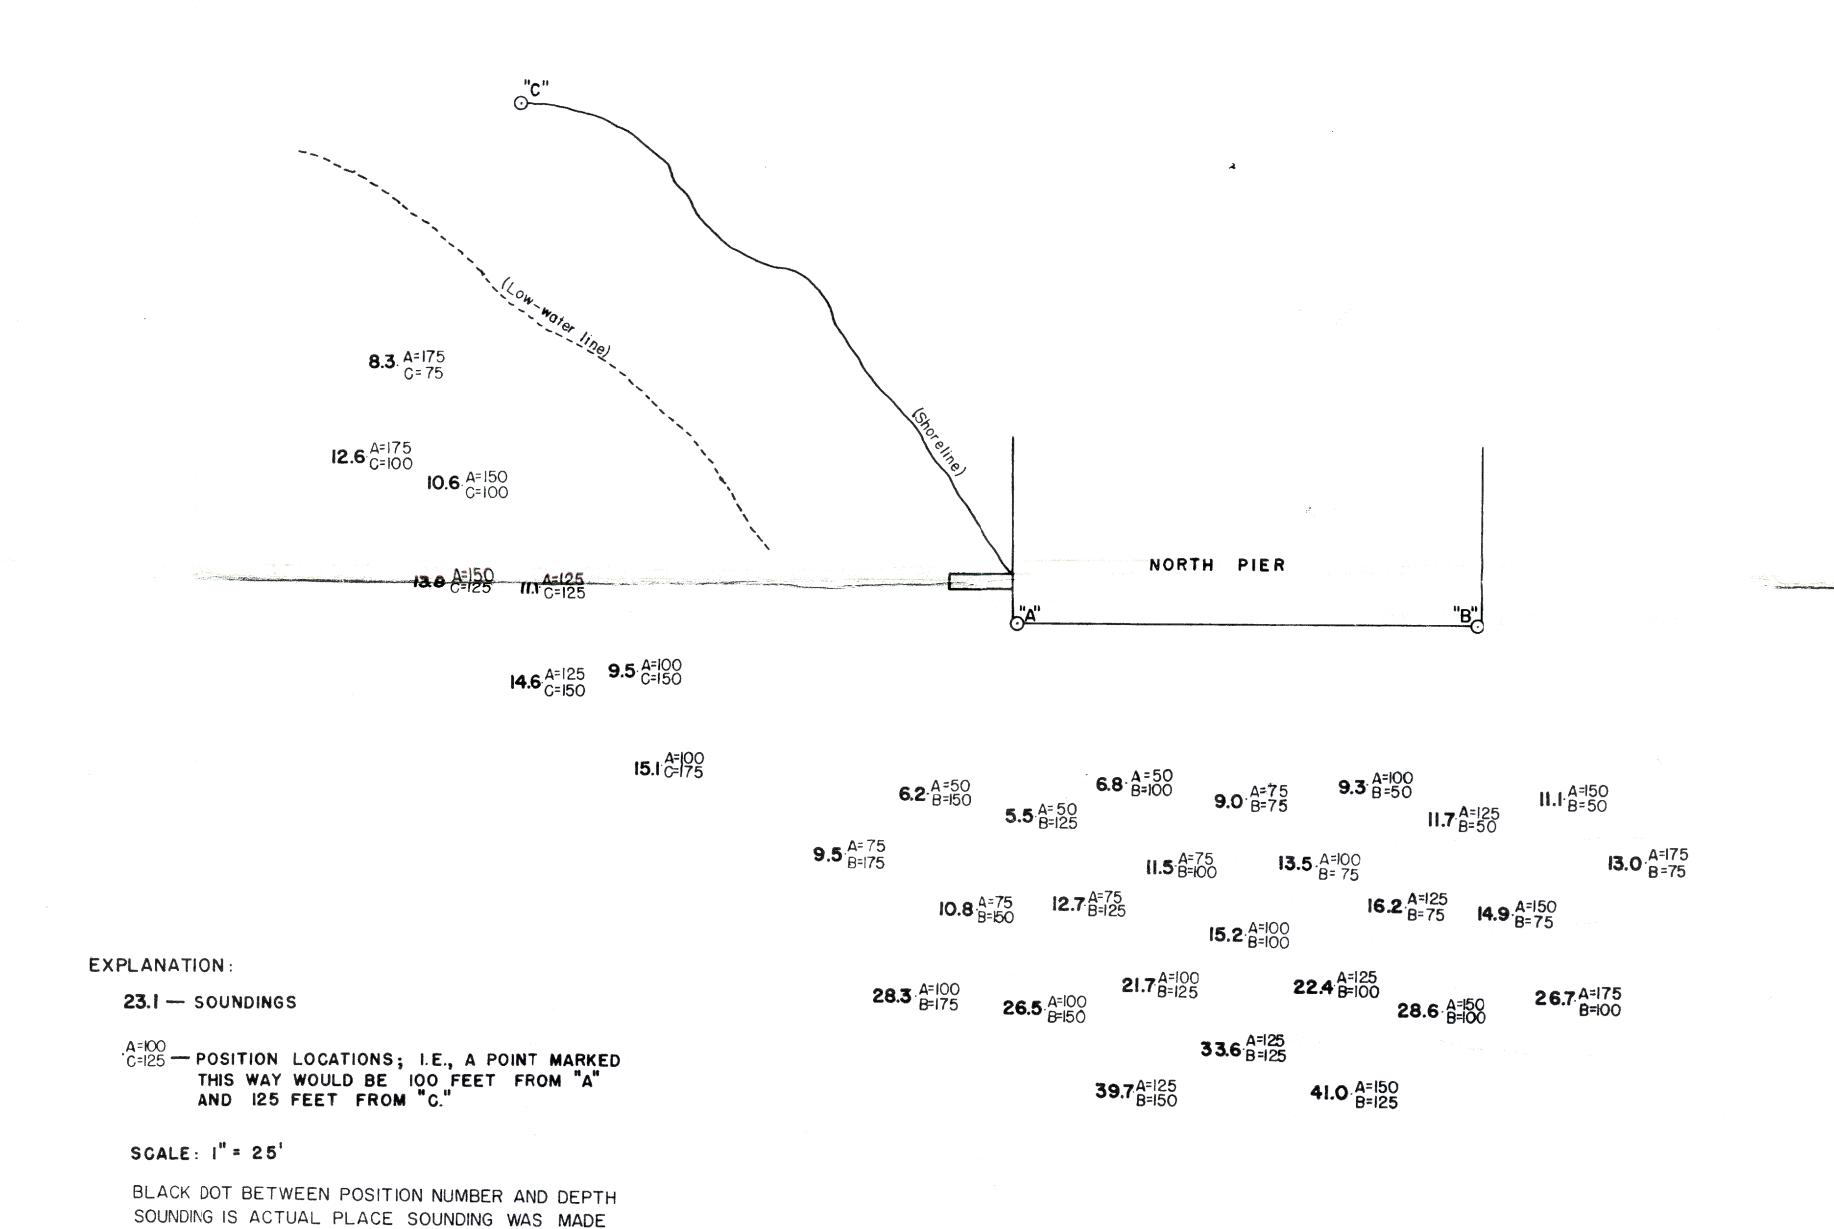

GOLDEN GATE BRIDGE NORTH (MARIN) PIER

HYDROGRAPHIC SURVEY

UNITED STATES COAST AND GEODETIC SURVEY
H. ARNOLD KARO, DIRECTOR

Charts 5532 We can Q4 & 224-65(Q4H)

Soundings in FEET

AT MEAN LOWER LOW WATER

1658ct Smeet 6

10 OCTOBER 1964 CONTINUE

10 OCTOBER 1964 CONTINUE

10 OCTOBER 1964 CONTINUE

10 OCTOBER 1964 CONTINUE

11 OCTOBER 1964 CONTINUE

12 OCTOBER 1964 CONTINUE

12 OCTOBER 1964 CONTINUE

13 OCTOBER 1964 CONTINUE

14 OCTOBER 1964 CONTINUE

15 OCTOBER 1964 CONTINUE

15 OCTOBER 1964 CONTINUE

16 OCTOBER 1964 CONTINUE

17 OCTOBER 1964 CONTINUE

18 OCTOBER 1964 CONTINUE

12 OGTOBER 1964 POSITIONS PLOTTED BY: F.G.P.
" VERIFIED BY: PWL

SOUNDINGS " BY: PWL

FA GARAGE

### NAUTICAL CHART DIVISION

### **RECORD OF APPLICATION TO CHARTS**

FILE WITH DESCRIPTIVE REPORT OF SURVEY NO. \_ F.E.No.4, 1964

### **INSTRUCTIONS**

- A basic hydrographic or topographic survey supersedes all information of like nature on the uncorrected chart.

- Letter all information.
   In "Remarks" column cross out words that do not apply.
   Give reasons for deviations, if any, from recommendations

CHART	DATE	CARTOGRAPHER	REMARKS
			Full Part Before After Verification Review Inspection Signed Via
			Drawing No.
5532	2-24-65	a. J. Lunday	Full Manual After Verification Review Inspection Signed Via
<u> </u>	22,00		Drawing No. thru 5535, no critical con.
			Full Part Before After Verification Review Inspection Signed Via
			Drawing No.
			Full Part Before After Verification Review Inspection Signed Via
			Drawing No.
· · · · · · · · · · · · · · · · · · ·			Full Part Before After Verification Review Inspection Signed Via
			Drawing No.
		<u> </u>	